


AB GP 0001480-401
ARMADA
TARRAGON EYREMORE
401 GAS PLANT SWEET
LICENSEE: HUSKY OIL OPERATIONS LTD
OPERATOR: HUSKY OIL OPERATIONS LTD

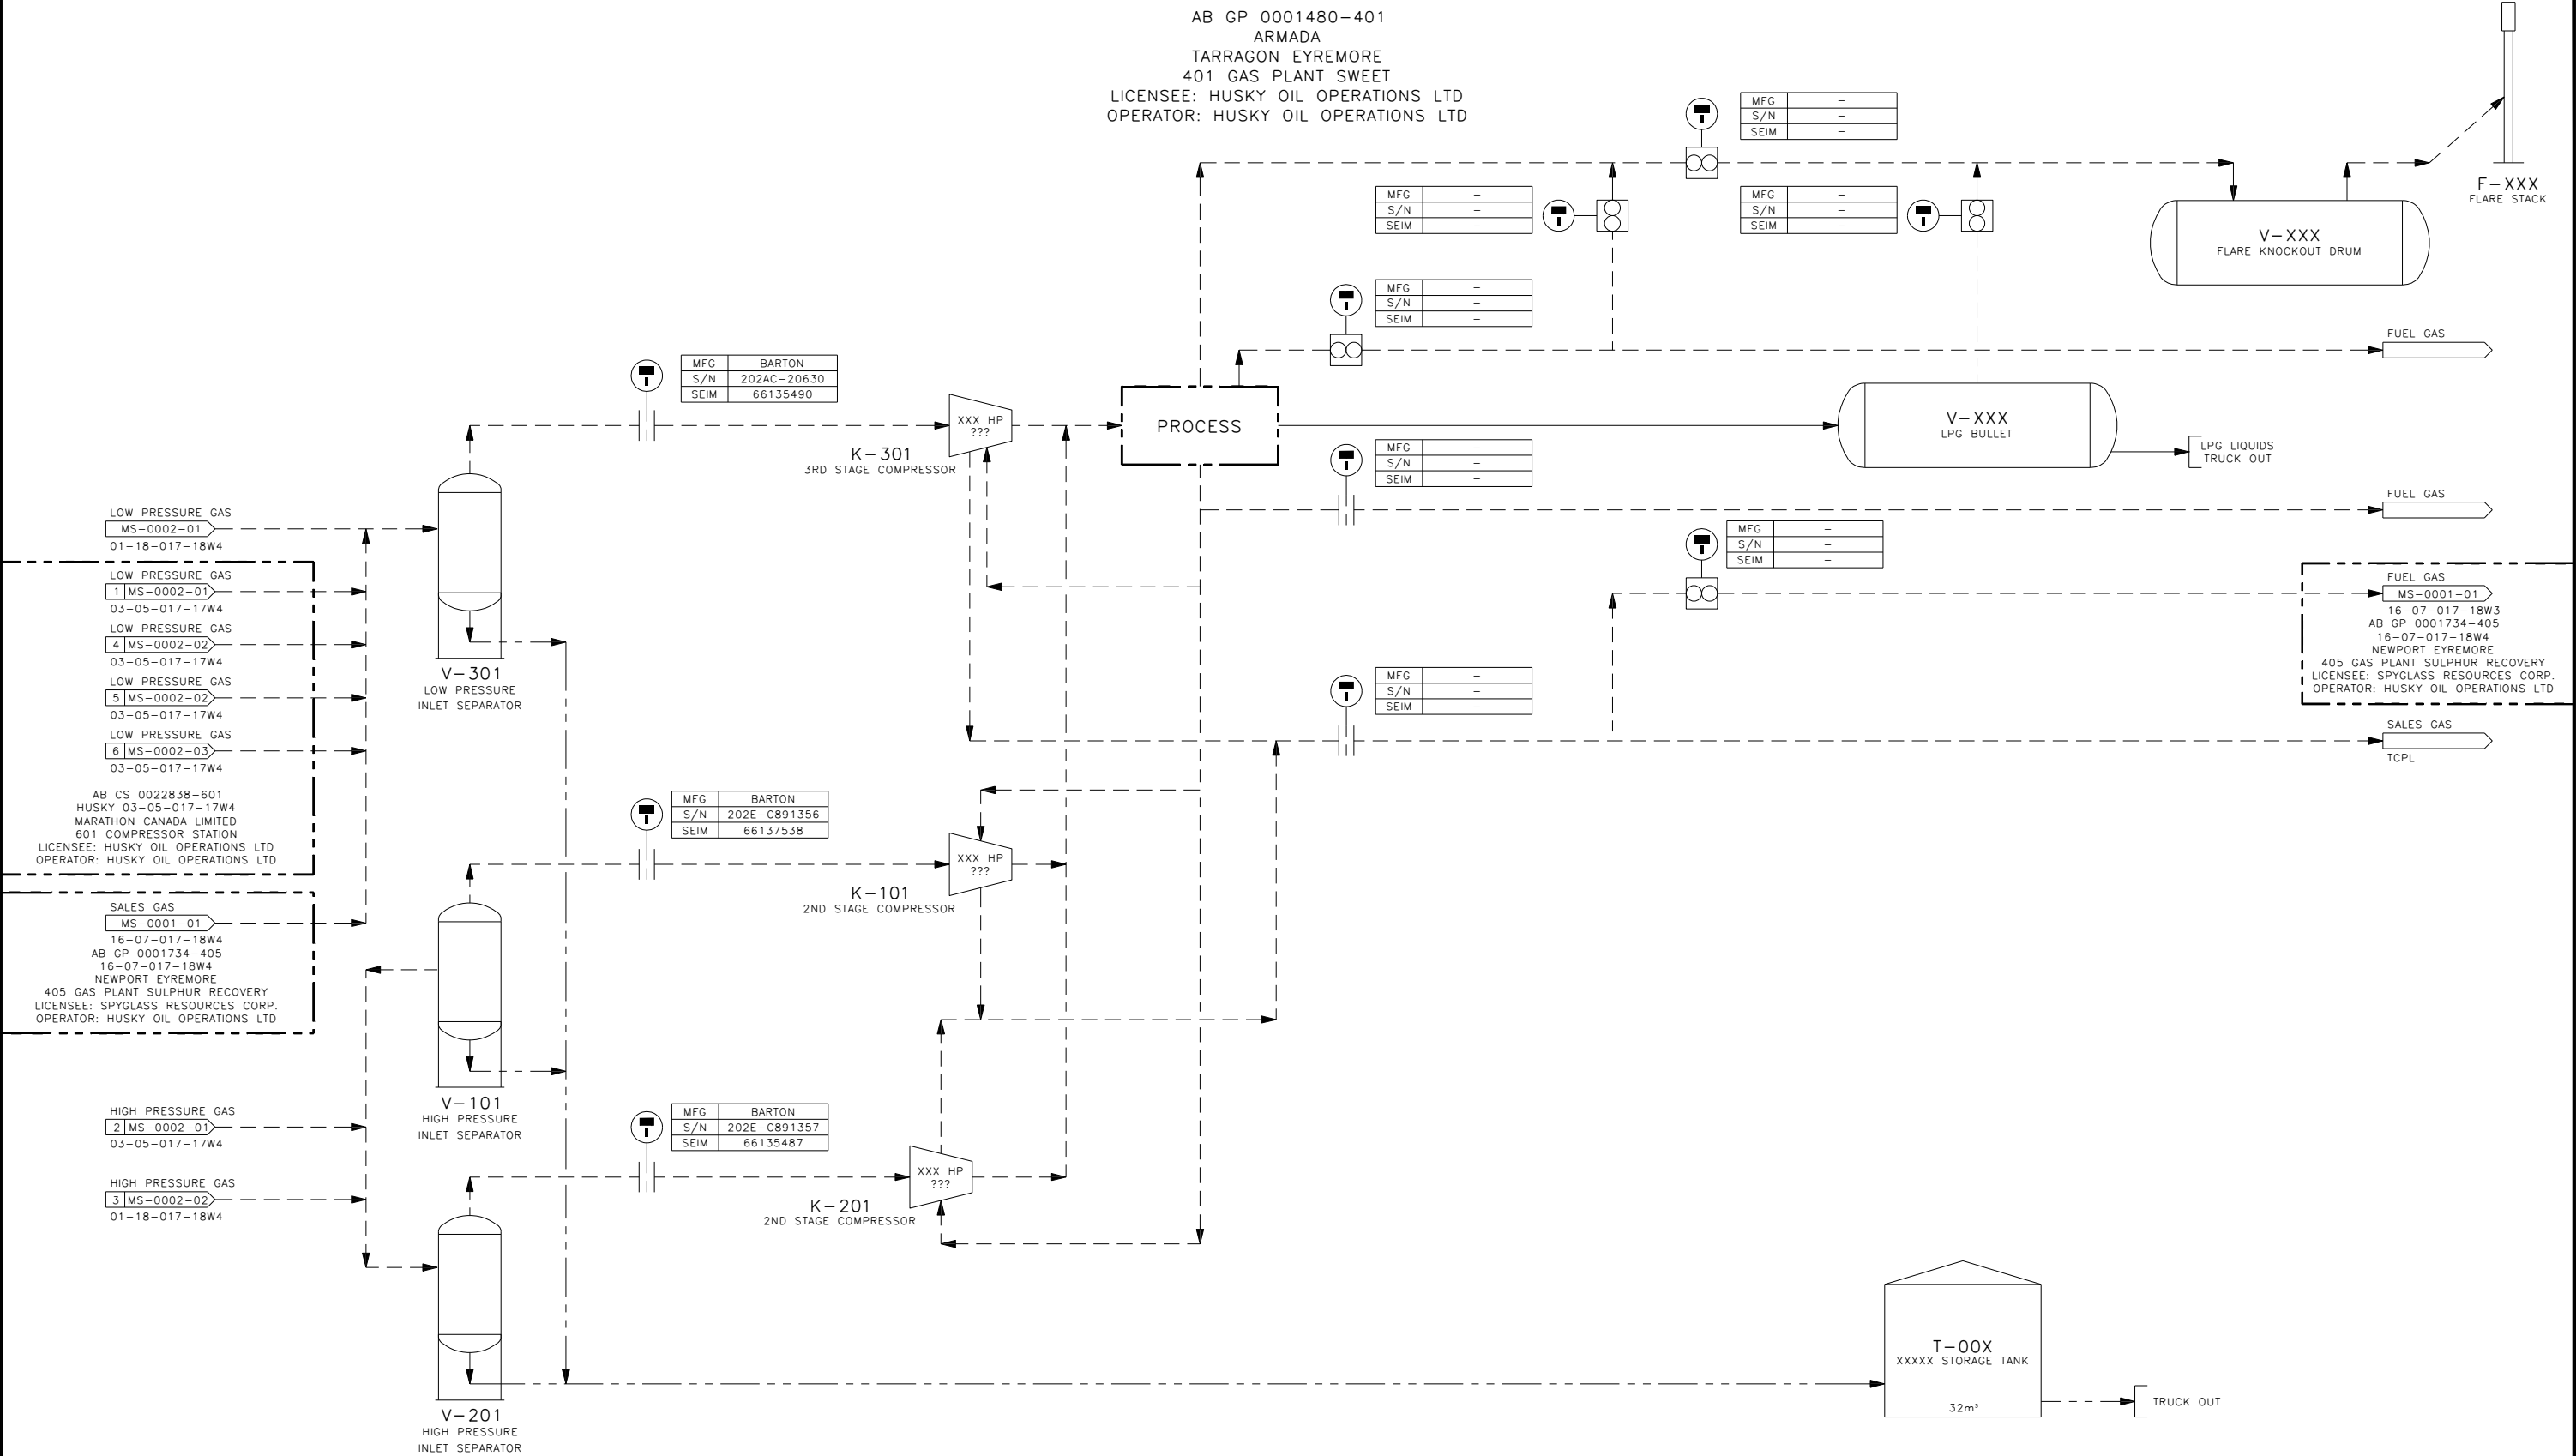

CC 21546

REF DWG NO	REFERENCE DRAWING DESCRIPTION	NO	REVISION HISTORY	REV AUTHOR	REV DATE	ISSUED FOR	NO	CURRENT REVISION	ISSUED FOR	AS BUILT
MS-0002-01	GATHERING SYSTEM MEASUREMENT SCHEMATIC	8	UPDATED PER MARK UPS FROM ROB SCHAAFSMA	KZ	2014/04/09	AS BUILT	9	UPDATED FROM MARK JOHNSON MARK UPS	DOC DATE	2015/03/26
MS-0002-02	GATHERING SYSTEM MEASUREMENT SCHEMATIC	2	UPDATED PER FIELD SUPPLIED MARK UPS	TCG	2006/10/24	AS BUILT			DOC AUTHOR	KD
MS-0002-04	GATHERING SYSTEM MEASUREMENT SCHEMATIC	3	PREPARED FOR AS BUILT CC 21546	GO	2009/03/27	AS BUILT			SCALE	NTS
MS-0002-05	GATHERING SYSTEM MEASUREMENT SCHEMATIC	4	UPDATED PER MARK UPS FROM PERRY ELLIOTT	PJC	2012/04/24	AS BUILT			ALTERNATE IDENTIFIER	
MS-0001-01	16-07-017-18W4-MS-0001-01 FACILITY DRAWING MEASUREMENT SCHEMATIC	5	METADATA UPDATE		2012/06/18				SURFACE LSD	01-18-017-18W4
MS-0001-01	03-05-017-17W4-MS-0001-01 FACILITY DRAWING MEASUREMENT SCHEMATIC	6	UPDATED AS PER MARK UPS FROM ROB SCHAAFSMA	PJC	2013/05/23	AS BUILT			DOCUMENT IDENTIFIER	MS-0001-01
		7	UPDATED AS PER MARK UPS FROM ROB SCHAAFSMA	PJC	2013/06/19	AS BUILT				

Husky Oil Operations Limited

ARMADA 01-18-017-18W4 GAS PLANT
FACILITY DRAWING
MEASUREMENT SCHEMATIC

CAD DRAWING: DO NOT CHANGE MANUALLY